

Available Suites

1528 E WILLIAMS FIELD RD

SUITE 202: $\pm 8,176$ SF¹ (AVAILABLE 03/01/2027)

SUITE 205: $\pm 6,403$ SF¹ $\pm 14,579$ SF

¹CONTIGUOUS TO $\pm 14,579$ SF | \$31.00 SF NNN

AS-BUILT FLOOR PLAN




Available Suites

1528 E WILLIAMS FIELD RD

SUITE 202: $\pm 8,176$ SF¹ (AVAILABLE 03/01/2027) | \$31.00 SF NNN | ¹CONTIGUOUS TO $\pm 14,579$ SF

AS-BUILT FLOOR PLAN

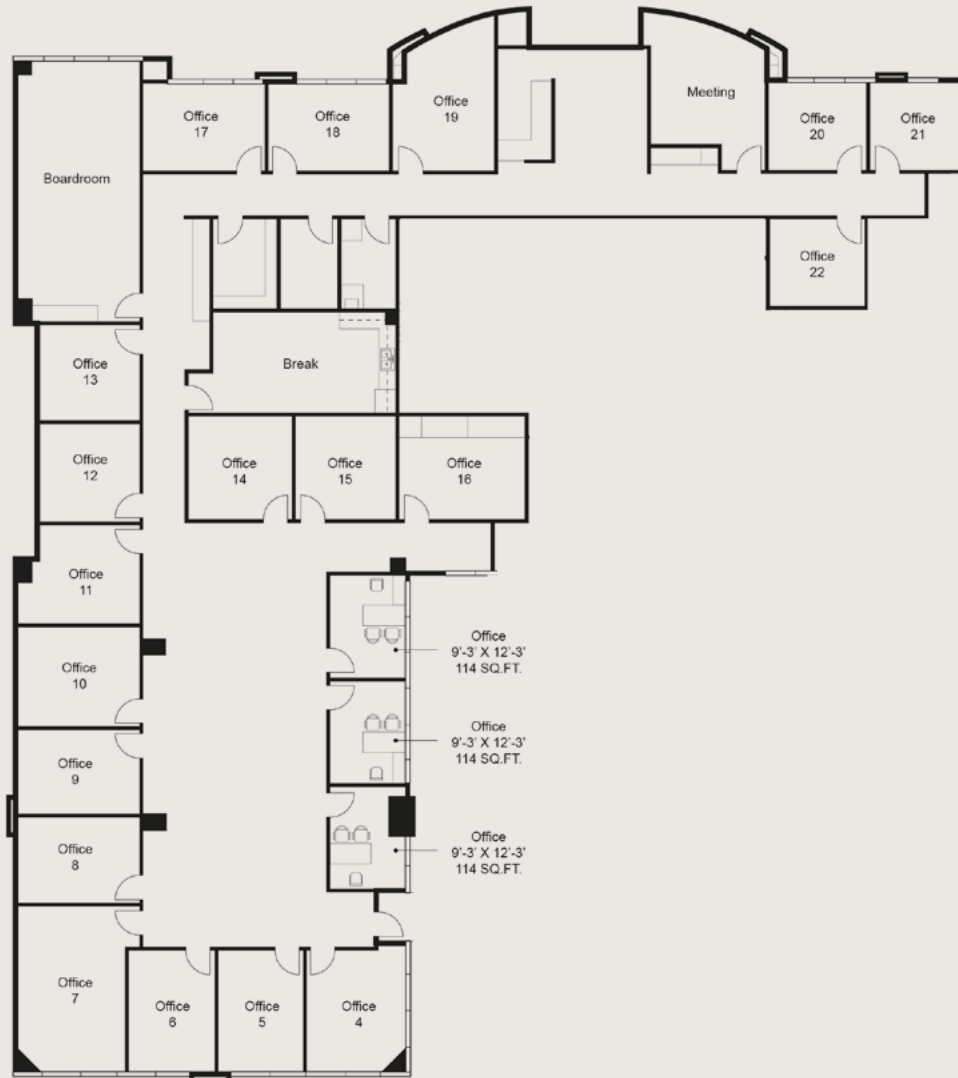


Available Suites


1528 E WILLIAMS FIELD RD

SUITE 205: $\pm 6,403$ SF¹ | \$31.00 SF NNN | ¹CONTIGUOUS TO $\pm 14,579$ SF

AS-BUILT FLOOR PLAN

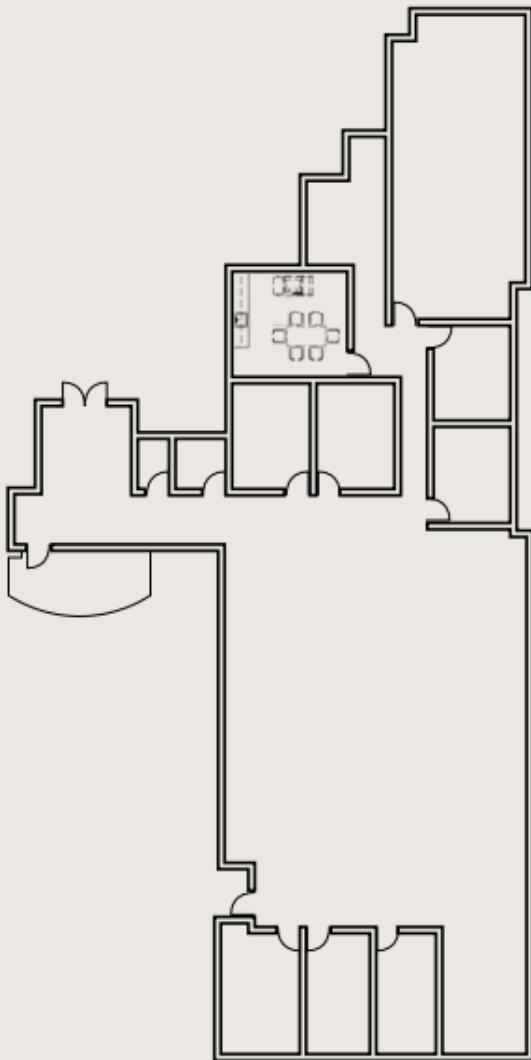

CONCEPTUAL OFFICE FLOOR PLAN: OPEN LAYOUT

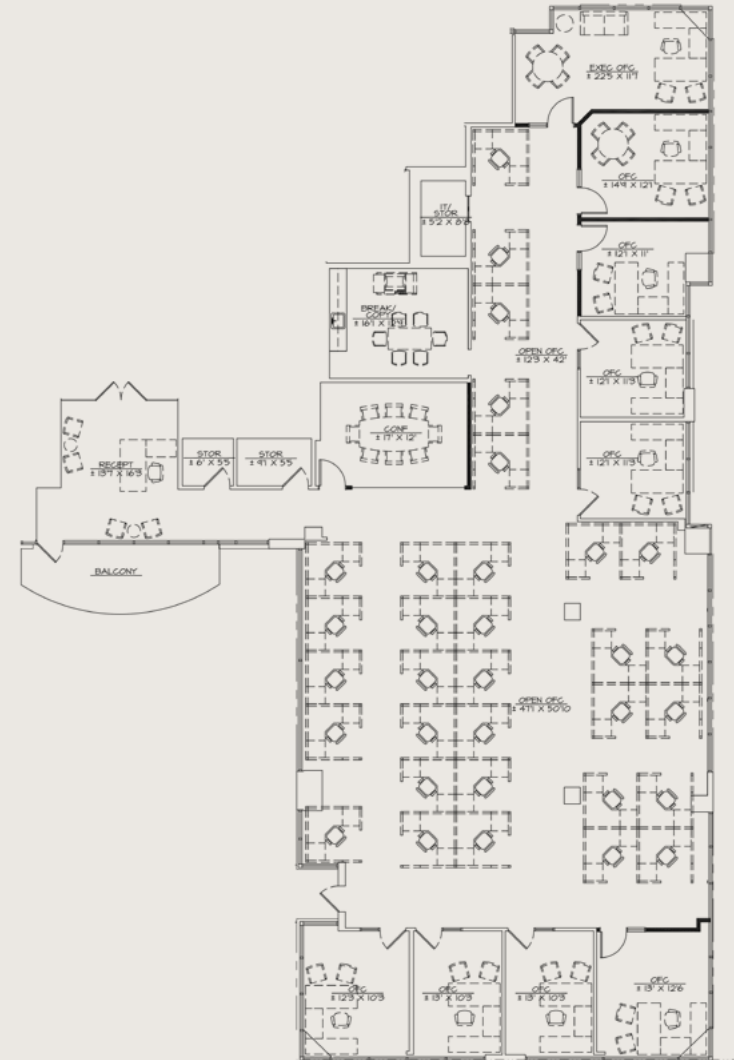

Click Here For
Virtual Tour




Available Suites

1528 E WILLIAMS FIELD RD

SUITE 205: ±6,403 SF¹ | \$31.00 SF NNN | ¹CONTIGUOUS TO ±14,579 SF

CONCEPTUAL OFFICE FLOOR PLAN: PRIVATE OFFICES LAYOUT

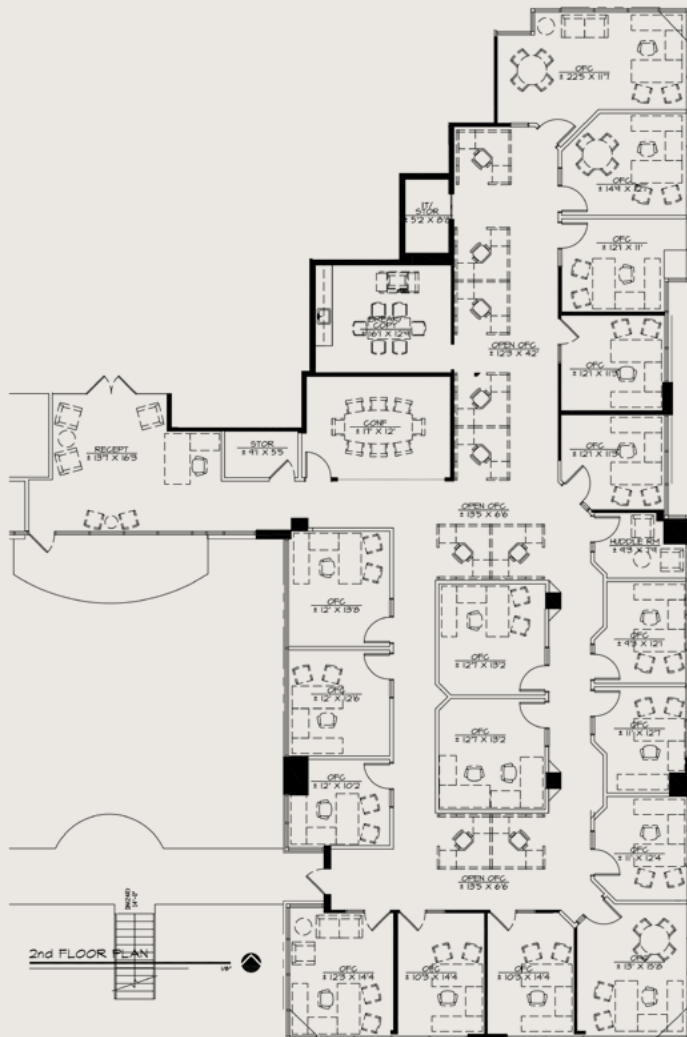

CONCEPTUAL MEDICAL FLOOR PLAN

