


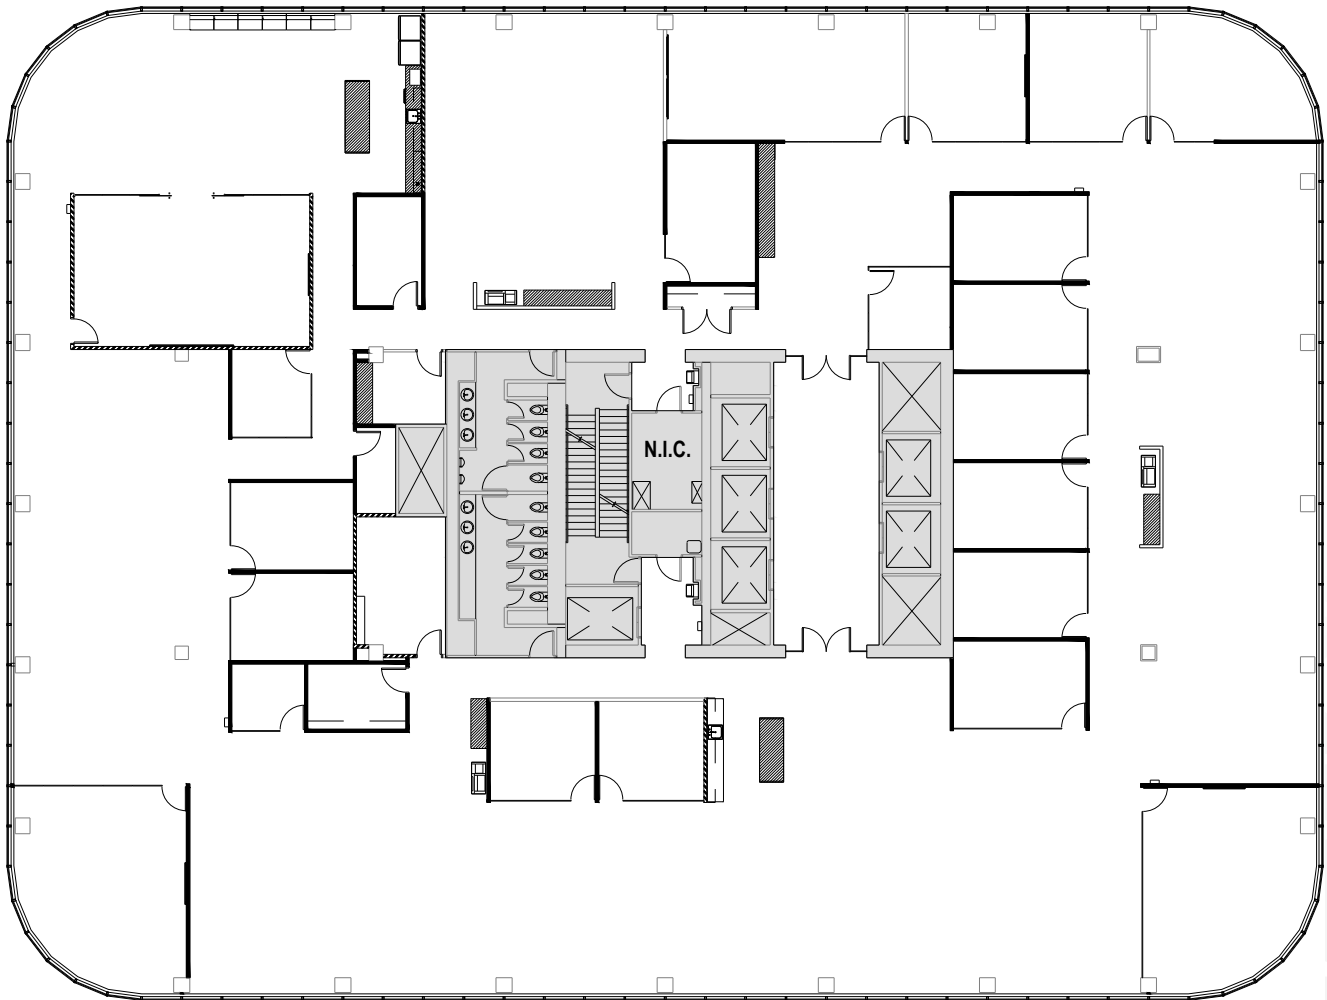

FLOOR 19 | SUITE 1800
21,087 SF

AS BUILT



SARAJANE GOODFELLOW
1 303 628 7414
sarajane.goodfellow@cbre.com

ALLISON BERRY
1 303 628 7456
allison.berry@cbre.com

Hines
CBRE

© 2023 CBRE, Inc. All rights reserved. This information has been obtained from sources believed reliable, but has not been verified for accuracy or completeness. You should conduct a careful, independent investigation of the property and verify all information. Any reliance on this information is solely at your own risk. CBRE and the CBRE logo are service marks of CBRE, Inc. All other marks displayed on this document are the property of their respective owners, and the use of such logos does not imply any affiliation with or endorsement of CBRE. Photos herein are the property of their respective owners. Use of these images without the express written consent of the owner is prohibited.

